



Texas Department of Housing and Community Affairs

Governing Board

Board Action Request

File #: 1636

Agenda Date: 11/5/2026

Agenda #:

Presentation, discussion, and possible action regarding a Material Amendment to the Housing Tax Credit Application for Covington Acres (HTC #25422)

RECOMMENDED ACTION

WHEREAS, Covington Acres (the Development) received a 4% Housing Tax Credit (HTC) award in 2025 for the new construction of 252 units of multifamily housing for the general population in Keene, Johnson County;

WHEREAS, to accommodate a 100-foot setback required by Atmos Energy, Covington Acres, LP (Development Owner or Owner) requests approval to increase the size of the Development site from 21.0748 acres to 23.9933 acres, which results in a 12.16% decrease in residential density, going from 11.957 units per acre to 10.503 units per acre;

WHEREAS, Board approval is required for a modification of the residential density of at least 5% as directed in Tex. Gov't Code §2306.6712(d)(6) and 10 TAC §10.405(a)(4)(F), and the Owner has complied with the amendment requirements therein; and

WHEREAS, the requested change does not materially alter the Development in a negative manner, was not reasonably foreseeable or preventable by the Owner at the time of Application, and would not have adversely affected the selection of the Application;

NOW, therefore, it is hereby

RESOLVED, that the requested material amendment of the Application for Covington Acres is approved as presented at this meeting, and the Executive Director and his designees are each authorized, directed, and empowered to take all necessary action to effectuate the Board's determination.

BACKGROUND

Covington Acres received a 4% Housing Tax Credit award in 2025 to construct 252 units of multifamily housing, all of which are designated as low-income units, for the general population in Keene, Johnson County. Construction of the Development is currently in progress. In a letter dated October 6, 2026, Rebecca Broadbent, the representative for the Owner, requested approval for a material amendment to the Application. The amendment is for a 12.16% decrease in the residential density, from 11.957 units per acre to 10.503 units per acre, which requires approval by the Board under Tex. Gov't Code §2306.6712(d)(6) and 10 TAC §10.405(a)

(4)(F). The change is the result of an increase in the Development site acreage from 21.0748 to 23.9933 acres, an increase of 2.9185 acres (13.85% increase).

At Application it was indicated that 21.8122 acres would be acquired, but 0.7374 acre would be dedicated for right of way. As a result, it was anticipated that the Land Use Restriction Agreement for the Development would encumber 21.0748 acres. However, during the permitting process, Atmos Energy required a 100-foot setback from the pipeline on the east side of the property. Additional acreage was purchased to accommodate this setback, increasing the land from the originally anticipated 21.8122 acres to 24.7308. However, there was a right-of-way dedication of 0.7375 acre, which resulted in 23.9933 acres for the Development. The additional acreage allowed for a site plan change to a layout similar to the site plan proposed at Application, and the units have not been affected by the change.

The Owner indicated that this change was unforeseeable at the time of Application and arose during the permitting process. The requested amendment does not materially alter the Development in a negative manner and would not have affected the selection of the Development for the HTC award.

Staff recommends approval of the requested material amendment to the Application.



October 6, 2026

Ms. Lucy Weber
Asset Manager (Region 3)
Texas Department of Housing and Community Affairs
221 East 11th Street
Austin, TX 78701

Re: Covington Acres, TDHCA #25422, Keene, TX

Dear Ms. Weber:

Please accept this formal request for a material amendment to #25422 Covington Acres. The Site was enlarged after Application, so the residential density has decreased.

Changes Requested

Density decrease of at least 5%. The site acreage has been increased from 21.8122 acres to 24.7308 acres. Accordingly, the density is decreasing from 15.30 units per acre to 18.36 units per acre, a difference of 11.8%.

Reason the Change is Necessary & Good Cause for the Change

During the permitting process, Atmos Energy required a 100' setback from the pipeline on the east side of the property. We were unaware of this requirement until after Application. We purchased additional acreage from the seller to accommodate this setback. The additional acreage allowed us to change the site plan without losing any units. The Site Plan layout is similar to what was proposed at Application and the units have not been affected by this change.

Explanation of Foreseeable or Preventable Nature

We did not know about the 100' setback required by Atmos Energy until we were well into the permitting process. By purchasing more land, we were able to keep the plan substantially the same and still accommodate the setback required by Atmos Energy.

As required, we are submitting the \$2,500 material amendment fee. Thank you for marshaling the amendment request through the system. Please feel free to contact me if you have any additional questions.

Sincerely,

A handwritten signature in black ink that reads "Rebecca Broadbent".

Rebecca Broadbent
Consultant to the Project

Attachments

A – Amendment Request Form

B.1 – Recorded Plat of the full site (24.7803 acres)

B.2 – Survey from Application (21.8122 acres)

C.1 – Site Plan approved for building permits

C.2 – Site Plan from Application

MATCHLINE SEE SHEET 2

LEGEND:

P.O.B. = POINT OF BEGINNING
 IRFC = IRON ROD WITH CAP FOUND
 IRSC = IRON ROD WITH RED PLASTIC CAP STAMPED "N&H" SET
 MNS = MAGNAN SET
 D.P.R.C.T. = OFFICIAL PUBLIC RECORDS, JOHNSON COUNTY, TEXAS
 D.R.C.T. = DEED RECORDS, JOHNSON COUNTY, TEXAS
 VOL. PG. = VOLUME/PAGE
 INST. NO. = INSTRUMENT NUMBER
 R.O.W. = RIGHT-OF-WAY

GENERAL NOTES:

1. Bearings are based State Plane Coordinate System, North Texas Central Zone 4202, North American Datum of 1983 (2011).
2. All corners are a 5/8" iron rod with plastic cap stamped "N&H" set unless otherwise noted.

FLOOD STATEMENT:


According to Federal Emergency Management Agency's Flood Insurance Rate Map No. 48251C01060, for Johnson County, Texas and incorporated areas, dated December 04, 2012, this property is located within:

Zone X (unshaded) defined as "Areas determined to be outside the 0.2% annual chance floodplain"

If this site is not within an identified special flood hazard area, this flood statement does not imply that the property and/or the structures thereon will be free from flooding or flood damage. On rare occasions, greater floods can and will occur and flood heights may be increased by man-made or natural causes. This flood statement shall not create liability on the part of the surveyor.



GRAPHIC SCALE IN FEET
 1" = 60' @ 24X36

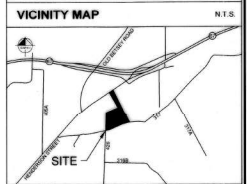

CURVE TABLE					CURVE TABLE				
NO.	DELTA	RADIUS	LENGTH	CHORD BEARING	CHORD	NO.	DELTA	RADIUS	LENGTH
C1	81°54'31"	25.00	4.07	S25°55'31"E	4.07	C18	80°45'00"	25.00	38.13
C2	7°58'57"	28.00	44.42	S25°54'56"E	44.38	C19	80°00'00"	25.00	38.27
C3	80°00'00"	25.00	39.27	S25°53'31"E	39.36	C20	80°00'00"	25.00	38.27
C4	45°00'00"	51.00	40.06	N45°23'31"W	39.03	C21	7°58'57"	28.00	41.76
C5	80°00'00"	25.00	39.27	S25°54'29"W	39.36	C22	14°56'30"	25.00	6.52
C6	80°00'00"	51.00	80.11	S54°24'29"W	72.12	C23	80°00'00"	50.00	78.54
C7	80°00'00"	51.00	80.11	N25°53'31"W	72.12	C24	80°00'00"	25.00	38.27
C8	80°00'00"	25.00	39.27	N25°53'31"W	39.36	C25	80°00'00"	25.00	38.27
C9	80°00'00"	25.00	39.27	S54°24'29"W	39.36	C26	80°00'00"	25.00	38.27
C10	40°11'48"	36.00	21.55	N15°13'33"W	20.02	C27	45°00'00"	51.00	40.06
C11	52°45'51"	36.00	18.71	N25°53'31"W	18.41	C28	80°00'00"	25.00	38.27
C12	37°03'34"	30.00	19.38	N25°36'31"W	19.08	C29	45°00'00"	25.00	19.63
C13	70°45'58"	30.00	45.15	N25°27'47"W	37.22	C30	83°28'12"	25.00	38.26
C14	4°59'08"	75.00	6.01	S54°41'19"W	6.01	C31	15°40'00"	125.00	34.46
C15	21°53'13"	75.00	29.03	N45°53'30"W	28.86	C32	22°19'54"	74.00	34.84
C16	80°00'00"	51.00	80.11	N25°53'31"W	72.12	C33	80°00'00"	25.00	38.27
C17	80°00'00"	51.00	80.11	N64°34'29"E	72.12	C34	45°00'00"	51.00	40.06

CURVE TABLE				
NO.	DELTA	RADIUS	LENGTH	CHORD BEARING
C35	22°19'54"	125.00	38.89	S37°53'28"E
C36	22°19'54"	125.00	38.89	N37°53'28"E
C37	45°00'00"	51.00	40.06	N45°23'31"W
C38	15°40'00"	51.00	125.17	N45°23'31"W
C39	45°00'00"	25.00	19.63	N45°23'31"W
C40	80°00'00"	25.00	39.27	S75°53'31"E
C41	45°00'00"	25.00	19.63	S55°23'31"E
C42	80°00'00"	51.00	80.11	S25°53'31"E
C43	45°00'00"	25.00	19.63	S45°23'31"E
C44	135°00'00"	25.00	88.89	S41°24'29"W
C45	80°00'00"	25.00	39.27	N25°53'31"W
C46	80°00'00"	30.00	47.12	N45°24'29"E
C47	80°00'00"	25.00	39.27	S25°53'31"E
C48	80°00'00"	25.00	39.27	S54°24'29"W
C49	80°00'00"	25.00	39.27	N25°53'31"W

PLAT FILED: 7/22/2025
 INSTRUMENT: 2025-05
 DRAWER: Q SLIDE
 APRIL 09, JOHNSON COUNTY CLERK
 BY: [Signature] DEPUTY CLERK

FINAL PLAT
 COVINGTON ACRES ADDITION
 LOT 1, BLOCK A
 BEING A PLAT OF A 24.7308 ACRE TRACT
 IN THE HUGH MCCOLLUM SURVEY,
 ABSTRACT NO. 570
 CITY OF KEENE, JOHNSON COUNTY, TEXAS

Kimley»Horn

2500 Pacific Avenue
 Suite 1100, Dallas, Texas 75226
 FIRM # 10115500 Tel. No. (469) 718-8848
 Scale: 1" = 60' Drawn by: LDV Checked by: JAD Date: Jul. 2025 Project No.: 068918006 Sheet No.: 1 OF 2

SURVEYOR:
 KIMLEY-HORN AND ASSOCIATES, INC.
 2500 PACIFIC AVENUE, SUITE 1100
 DALLAS, TEXAS 75226
 CONTACT: ANDY DOBBS@KIMLEY-HORN.COM
 PHONE: 972-770-1300

ENGINEER:
 KIMLEY-HORN AND ASSOCIATES, INC.
 225 E. JOHN W. CARPENTER FREEWAY
 SUITE 1100
 IRVING, TEXAS 75062
 CONTACT: BLAZE.BOWDENS@KIMLEY-HORN.COM
 PHONE: 214-420-5520

OWNER:
 TEXAS HOUSING FOUNDATION
 1100 BROADWAY STREET
 MARBLE FALLS, TEXAS 78654
 CONTACT: AMILLICORNS@TXHF.ORG
 PHONE: (830) 693-3100

BENCHMARK LIST

BM 400 MAG NAIL SET ON THE NORTH ASPHALT
LINE OF COUNTY ROAD 317 15'4" NORTH
OF THE CENTERLINE OF COUNTY ROAD
317 AND 37'4" WEST OF THE CENTERLINE
OF COUNTY ROAD 426.

ELEV=856.11

BM 401 MAG NAIL SET ON THE NORTH ASPHALT
LINE OF COUNTY ROAD 317 188'7" EAST
OF THE CENTERLINE OF COUNTY ROAD
426 AND 115'4" NORTH OF THE
CENTERLINE OF COUNTY ROAD 317.

ELEV=847.89

BM 402 MAG NAIL SET ON THE NORTH ASPHALT
LINE OF COUNTY ROAD 317 15'2" NORTH
OF THE CENTERLINE OF COUNTY ROAD
317 AND 138'4" EAST OF THE
CENTERLINE OF COUNTY ROAD 426.

ELEV=848.67

ENRIOL B. BRUCE, HORTENSIA
MARIE BRUCE, DONA
COREY DOCKERY AND NELSON
DOCKERY
INST. NO. 2014-1197
O.P.R.J.C.T.
PROPERTY ID: 8000020948

ANGIEA HOUNG SI HANG
INST. NO. 2010-014431
O.P.R.J.C.T.
PROPERTY ID: 8000020952

ELECTRIC DISTRIBUTION
LINE EASEMENT CENTERLINE
(VOL. 987, PG. 255)
D.R.J.C.T.

REMAINDER OF
ARGO TRANSPORTATION LLC
INST. NO. 2002-0136
D.R.J.C.T.
PROPERTY ID: 8000014602

PART OF
ARGO TRANSPORTATION LLC
INST. NO. 2002-0136
D.R.J.C.T.
PROPERTY ID: 8000014602
21.8122 ACRES
950,140 SQ. FT.

STEVEN CAULEY AND
WIFE, LORRAE CAULEY
DOC. NO. 2003-24881
O.P.R.J.C.T.
PROPERTY ID: 8000014673

MATCHLINE SEE SHEET 2

COUNTY ROAD 317
(A PRESCRIPTIVE RIGHT-OF-WAY)

COUNTY ROAD 426

NOTES:

- Monuments shown hereon are 5/8-inch iron rods with red plastic caps stamped "KHA" set (unless otherwise noted).
- Address listed on the Johnson County Appraisal District website at the time of the survey was listed as 2632 E Highway 67, Cleburne, Texas 76033.
- The surveyor did not observe any evidence of parking on the subject site at the time of the survey.
- There was no visible evidence of current earth moving work, building construction or building additions were observed at the time of the survey.
- The surveyor was not provided with a current zoning report at the time of the survey.
- The surveyor did not observe any buildings on the subject property at the time of the survey.
- The southwest corner of the subject property is in the intersection of County Road 482 at County Road 317.
- There was no evidence of recent street or sidewalk construction or repairs observed at the time of the survey.
- Any underground utilities shown hereon are from Texas 911 mappings or other third party utility locators and located by survey crews, or record drawings obtained from our client or utility companies representatives. Said locates are combined with observed evidence of utilities to develop a view of the underground utilities. However, lacking excavation, the exact location of the underground features cannot be accurately, completely and reliably depicted. Kimley-Horn assumes no liability for poorly or improperly marked utility locations. Private interior service lines are not shown.

FLOOD STATEMENT:

According to Federal Emergency Management Agency's Flood Insurance Rate Map No. 46257C0100L for Johnson County, Texas and incorporated areas, dated December 04, 2012, this property is located within

Zone X (unshaded) defined as "Areas determined to be outside the 0.2% annual chance floodplain"

If this site is not within an identified special flood hazard area, this flood statement does not imply that the property and/or the structures thereon will be free from flooding or flood damage. On rare occasions, greater floods can and will occur and flood heights may be increased by man-made or natural causes. This flood statement shall not create liability on the part of the surveyor



GRAPHIC SCALE IN FEET
1" = 80' @ 24 X 36"

VICINITY MAP



LEGEND


1	ROOF DRAIN	55	WALL END
2	PIPE TYPICAL	56	PIPE TYPICAL
3	CABLE TV HANDHOLE	57	PAVEMENT
4	CABLE TV HANDHOLE	58	PAVEMENT
5	CABLE TV HANDHOLE	59	PAVEMENT
329	CABLE TV HANDHOLE	383	PAVEMENT
330	CABLE TV HANDHOLE	384	PAVEMENT</

FLOOD STATEMENT:

According to Federal Emergency Management Agency's Flood Insurance Rate Map No. 4821C0190, for Johnson County, Texas and incorporated areas, dated December 04, 2012, this property is located within

Zone X (unshaded) defined as "Areas determined to be outside the 0.2% annual chance floodplain"

If this site is not within an identified special flood hazard area, this flood statement does not imply that the property and/or the structures thereon will be free from flooding or flood damage. On rare occasions, greater floods can and will occur and flood heights may be increased by man-made or natural causes. This flood statement shall not create liability on the part of the surveyor

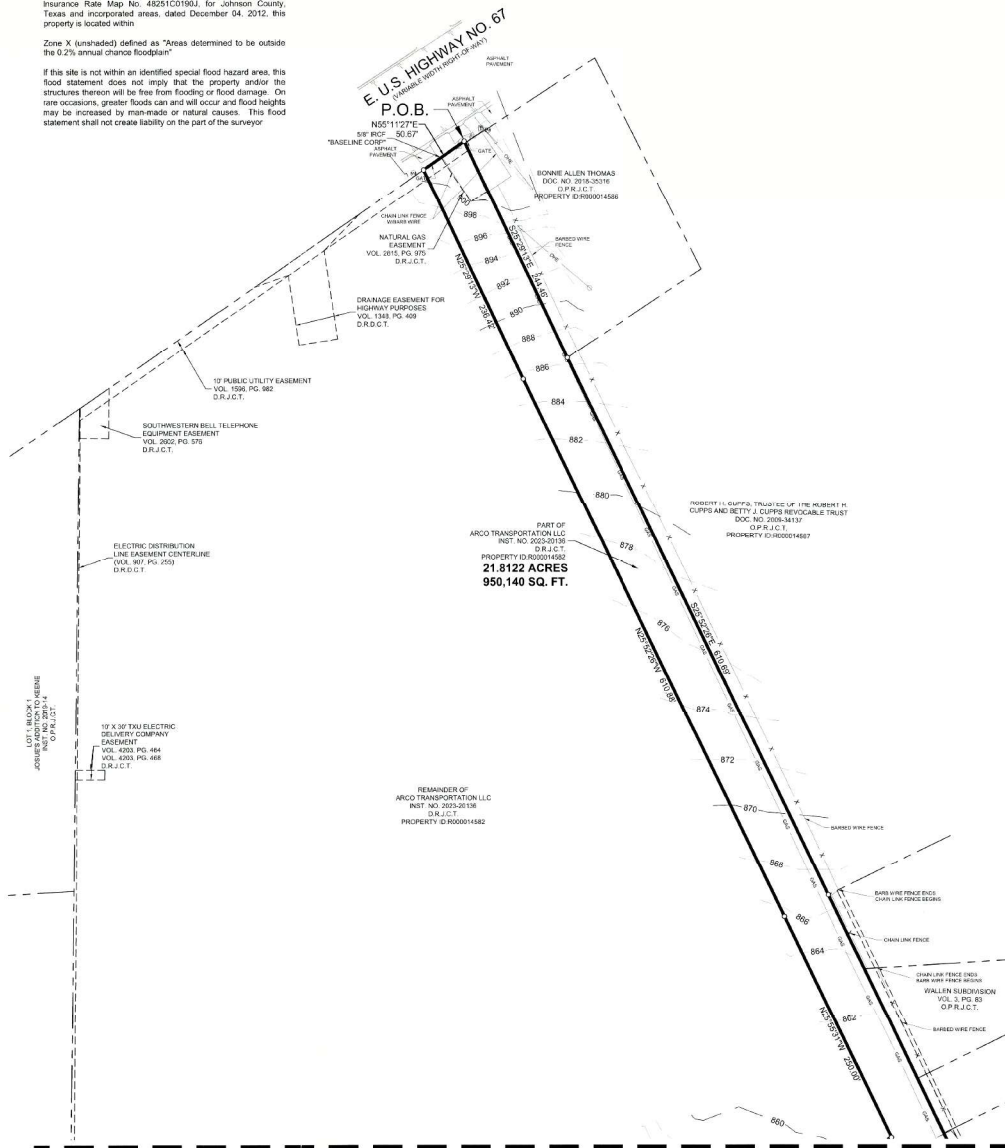

MATCHLINE SEE SHEET 1

NOTES ADDRESSING SCHEDULE B EXCEPTIONS:

(Pursuant to Commitment for Title Insurance, issued by First American Title Insurance Company, GF. No. 5188112-F-TX-CP-IND, effective date April 3, 2024, issued, April 19, 2024.)

- Item No. 1, Schedule B, is hereby deleted.
- The subject property is part of the property described in Lone Star Gas Co. Easement recorded in Volume 269, Page 350 of the Deed Records of Johnson County, Texas. Easement mentioned in the western property line is blanket in nature.
- Due to the vague description of Easement and Right-of-Way to Texas Power & Light Co. recorded in Volume 326, Page 149 of the Deed Records of Johnson County, Texas, the surveyor was unable to determine its exact location.
- The Easement to Texas Power & Light Co. recorded in Volume 341, Page 392 of the Deed Records of Johnson County, Texas does not lie within the subject property.
- Due to the vague description of Easement to American Telephone and Telegraph Co. recorded in Volume 410, Page 401 of the Deed Records of Johnson County, Texas, the surveyor was unable to determine its exact location.
- The Electric Distribution Line Easement to Texas Power & Light Company recorded in Volume 907, Page 255 lies within the subject property and is shown hereon.
- The Drainage Easement for Highway Purposes to State of Texas recorded in Volume 1348, Page 408 of the Deed Records of Johnson County, Texas, does not lie within the subject property.
- The Easement and Right of Way to Texas Utilities Electric Company recorded in Volume 1510, Page 50 of the Deed Records of Johnson County, Texas does not lie within the subject property.
- The Easement and Right-of-way recorded in Volume 1596, Page 982, Deed Records of Johnson County, Texas does not lie within the surveyed property and is shown hereon.
- The 10' Public Utility Easement recorded in Volume 2602, Page 576, Deed Records of Johnson County, Texas does not lie within the surveyed property.
- The Southwest Bell Telephone Equipment Easement recorded in Volume 2602, Page 576, Deed Records of Johnson County, Texas does not lie within the surveyed property.
- The Natural Gas Easement recorded in Volume 2815, Page 975, Deed Records of Johnson County, Texas does lie within the surveyed property and is shown hereon.
- The Easement and Right-of-way recorded in Volume 4203, Page 464, Deed Records of Johnson County, Texas does not lie within the surveyed property.
- The Easement and Right-of-way recorded in Volume 4203, Page 464, Deed Records of Johnson County, Texas does not lie within the surveyed property.
- The surveyed property is a portion of "Tract 2" described in the document recorded in Volume 3441, Page 933, Deed Records of Johnson County, Texas. This survey does not provide a determination or opinion concerning the mineral estates and interests and all rights incident thereto in the above recorded document. Only the mineral estate's location relative to the surveyed property was determined by the surveyor.
- The surveyed property is a portion of "Tract 2" described in the document recorded in Volume 3441, Page 937, Deed Records of Johnson County, Texas. This survey does not provide a determination or opinion concerning the mineral estates and interests and all rights incident thereto in the above recorded document. Only the mineral estate's location relative to the surveyed property was determined by the surveyor.
- The surveyed property is a portion of the property described in the document recorded in Instrument No. 2023-20136, Official Public Records of Johnson County, Texas. This survey does not provide a determination or opinion concerning the mineral estates and interests and all rights incident thereto in the above recorded document. Only the mineral estate's location relative to the surveyed property was determined by the surveyor.
- Due to the vague description of the Mineral Deed recorded in Instrument No. 2023-32930, Official Public Records of Johnson County, Texas the surveyor is unable to determine its exact location. This survey does not provide a determination or opinion concerning the mineral estates and interests and all rights incident thereto in the above recorded document. Only the mineral estate's location relative to the surveyed property was determined by the surveyor.
- The surveyed property is a portion of "Exhibit A" described in Ordinance No. 2002-182 recorded in Volume 2627, Page 636, Deed Records of Johnson County, Texas.

PROPERTY DESCRIPTION

BEING a tract of land situated in the Hugh McCollum Survey, Abstract No. 570, Johnson County, Texas and being a part of the certain tract of land described in Warranty Deed with Vendor's Lien to Arco Transportation LLC recorded in Instrument No. 2023-20136 of the Official Public Records of Johnson County, Texas and being more particularly described as follows:

BEGINNING at a 5/8" iron rod with "KHA" cap set in the southeast right-of-way line of E. Highway No. 67 (a variable width right-of-way) and being the north corner of said Arco Transportation LLC tract and being the northeast corner of the tract of land described in Grant Deed and Bill of Exchange to Bonnie Allen Thomas recorded in Instrument No. 2016-35316 of said Official Public Records;

THENCE with the northeast line of said Arco Transportation LLC tract, the following courses and distances:

North 25°29'13" East, a distance of 244.46 feet to a 5/8" iron rod with "KHA" cap set for corner;
 South 25°52'26" East, a distance of 610.89 feet to a 5/8" iron rod with "KHA" cap set for corner;
 South 25°50'31" East, a distance of 1,063.21 feet to a 5/8" iron rod with "KHA" cap set for corner in the approximate centerline of County Road 317 (a variable width right-of-way) and being the southeast corner of said part of Arco Transportation LLC tract;

THENCE with the said approximate centerline of County Road 317 and the southern lines of said Arco Transportation LLC tract, the following courses and distances:

South 72°59'13" West, a distance of 204.11 feet to a mag nail set for corner;
 South 69°22'49" West, a distance of 919.97 feet to a mag nail set for corner;
 South 77°30'31" West, a distance of 216.30 feet to a mag nail set at the southwest corner of said part of Arco Transportation LLC tract;

THENCE with the west line of said Arco Transportation LLC tract, the following courses and distances:

North 00°34'42" East, a distance of 513.99 feet to a 1/2" iron rod not found for corner;
 North 00°41'30" East, a distance of 291.90 feet to a 5/8" iron rod with "KHA" cap set for corner;

THENCE departing said west line of said Arco Transportation LLC tract, over and across said Arco Transportation LLC, the following courses and distances:

North 20°50'51" West, a distance of 250.00 feet to a 5/8" iron rod with "KHA" cap set for corner;
 North 25°52'26" East, a distance of 610.88 feet to a 5/8" iron rod with "KHA" cap set for corner;
 North 25°29'13" West, a distance of 236.42 feet to a 5/8" iron rod with "KHA" cap set for corner in the said southeast right-of-way line of E. Highway No. 67;

THENCE with said southeast right-of-way line of E. Highway No. 67, North 50°11'27" East, a distance of 50.67 feet to the **POINT OF BEGINNING** and containing 850,140 square feet or 21,812.2 acres of land.



SURVEYORS CERTIFICATION:

To: Kittle Property Group, Inc., an Indiana corporation;
 Arco Transportation LLC; and
 First American Title Insurance Company.

This is to certify that this map or plat and the survey on which it is based were made in accordance with the 2021 Minimum Standard Detail Requirements for ALTA/NSPS Land Title Surveys, jointly established and adopted by ALTA and NSPS, and includes Items 1, 2, 3, 4, 5, 6(a), 7(a), 7(c), 8, 9, 10, 11, 12, 13, 14, 15, 16, 17, 18, 19 and 20 of Table A thereof. The field work was completed on April 24, 2024.

Survey Date: May 1, 2024

J. Andy Dobbs
 Registered Professional Land Surveyor No. 6196
 Kimley-Horn and Associates, Inc.
 2500 Pacific Avenue, Suite 1100
 Dallas, Texas 75226
 PH: 469-718-8049
 andy.dobbs@kimley-horn.com

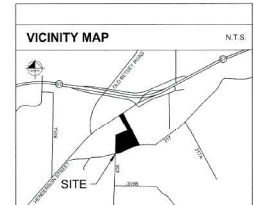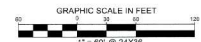


LEGEND

8	ROAD DRAIN	85	WALL BOX
9	LINE TO INTERSECT	86	POLE TOP
10	LINE TO INTERSECT	87	POLE TOP
11	LINE TO INTERSECT	88	POLE TOP
335	LINE TO INTERSECT	412	POLE TOP
336	LINE TO INTERSECT	413	

Additional acreage purchased

PROPOSED SITE PLAN
SCALE: 1:60

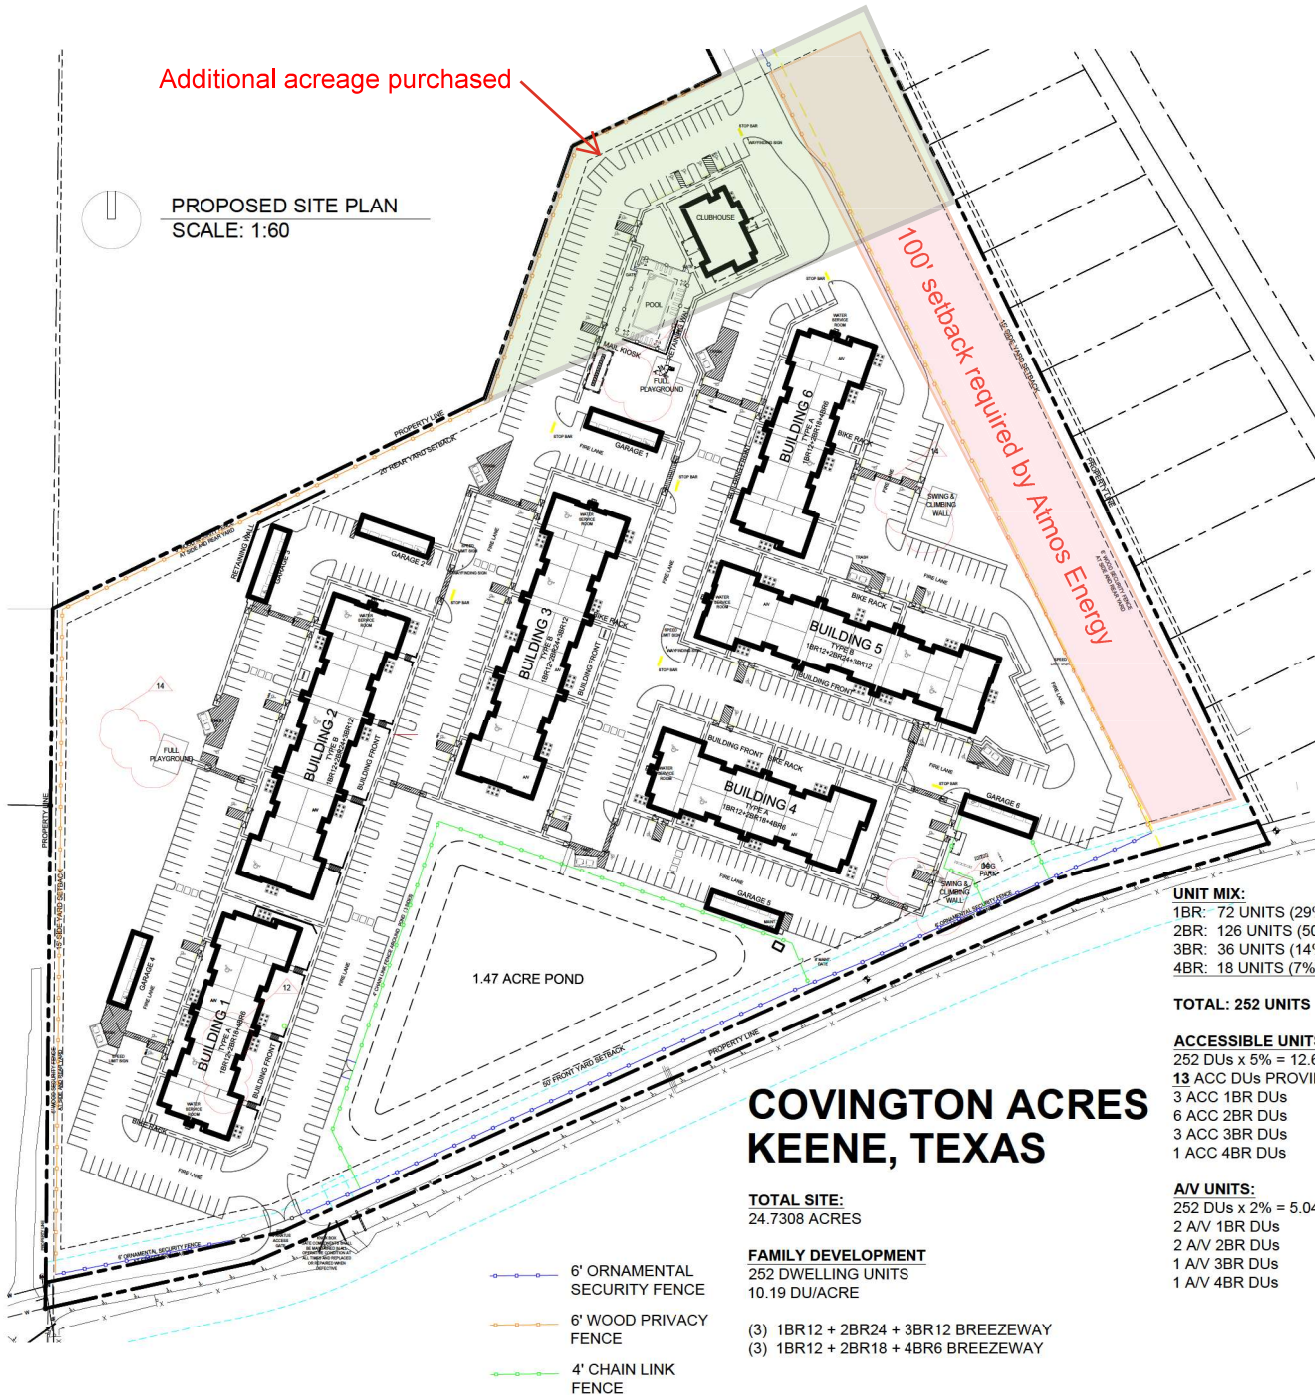

COVINGTON ACRES KEENE, TEXAS

TOTAL SITE:
24.7308 ACRES

FAMILY DEVELOPMENT
252 DWELLING UNITS
10.19 DU/ACRE

- (3) 1BR12 + 2BR24 + 3BR12 BREEZEWAY
(3) 1BR12 + 2BR18 + 4BR6 BREEZEWAY

UNIT MIX:
1BR: 72 UNITS (29%)
2BR: 126 UNITS (50%)
3BR: 36 UNITS (14%)
4BR: 18 UNITS (7%)


TOTAL: 252 UNITS

ACCESSIBLE UNITS:
252 DUs x 5% = 12.6
13 ACC DUs PROVIDED
3 ACC 1BR DUs
6 ACC 2BR DUs
3 ACC 3BR DUs
1 ACC 4BR DUs

A/V UNITS:
252 DUs x 2% = 5.04 = 6 A/V DUs
2 A/V 1BR DUs
2 A/V 2BR DUs
1 A/V 3BR DUs
1 A/V 4BR DUs

- 6" ORNAMENTAL
SECURITY FENCE
6" WOOD PRIVACY
FENCE
4" CHAIN LINK
FENCE

ENTRY ROAD
SCALE: 1:100

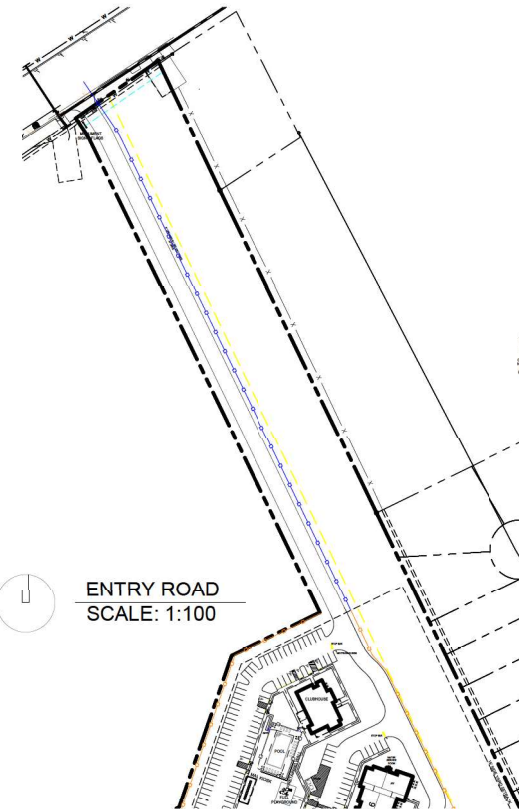

AMENITIES:
CLUBHOUSE
POOL
BARK PARK
1 PLAYGROUND
4 TOTAL PLAYGROUNDS (3 POCKET PLAYGROUNDS)
MAIL KIOSK
MONUMENT SIGN WITH FLAGS
BIKE RACKS
SECURITY FENCE
OVER 15% OF LAND DEDICATED TO
GREEN/PLAYGROUND SPACE

REQUIRED PARKING SPACES:
252 UNITS X 2.5 SPACES/UNIT = 630 SPACES
18 4BR UNITS X 1 SPACE/UNIT INCREASE = 18 SPACES
33 TOTAL ACCESSIBLE SPACES REQUIRED
6 TOTAL VAN SPACES REQUIRED
TOTAL 648 SPACES REQUIRED

PARKING SPACES PROVIDED:
648 SURFACE TOTAL PARKING SPACES
34 TOTAL ACC SURFACE SPACES PROVIDED
6 VAN ACC SURFACE SPACES PROVIDED
35 GARAGES SPACES
5 ACC GARAGE SPACES PROVIDED (2 REQ)
1 MAINTENANCE BAY



310 East 9th Street, Suite 400
Indianapolis, IN 46202
(317) 846-3111
www.kittleproperties.com

COPYRIGHT & OWNERSHIP OF
DOCUMENTS

THE INFORMATION CONTAINED HEREIN IS THE PROPERTY OF KITTLE PROPERTY GROUP, INC. AND IS NOT TO BE REPRODUCED OR TRANSMITTED IN ANY FORM OR BY ANY MEANS, ELECTRONIC OR MECHANICAL, INCLUDING PHOTOCOPYING, RECORDING, OR BY ANY INFORMATION STORAGE AND RETRIEVAL SYSTEM, WITHOUT THE WRITTEN PERMISSION OF KITTLE PROPERTY GROUP, INC.

1. COPYRIGHT 2025 KITTLE PROPERTY GROUP, INC.

SEAL



04.07.2025 REVISED 05.02.2025

PROJECT TITLE

COVINGTON ACRES

2444 US-37
KEENE, TEXAS 79031

ISSUED FOR: DATE
50% REVIEW SET 02/10/25
100% REVIEW SET 03/10/25
PRELIMINARY PERMIT SET 03/11/25
PERMIT SET 04/01/25
FINAL CONSTRUCTION SET 07/25/25

REVISIONS

MARK	DESCRIPTION	DATE
1	CITY COMMENT 1	05/02
2	RPT 1-11	05/07
3	FINAL CONSTRUCTION SET	07/25
4	RPT 10	08/18
5	RPT 11 (REVISED)	08/20
6	RPT 12	08/22
7	RPT 13	08/23
8	RPT 14	08/24
9	RPT 15	08/25
10	RPT 16	08/26
11	RPT 17	08/27
12	RPT 18	08/28
13	RPT 19	08/29
14	RPT 20	08/30

DO NOT SCALE PRINTS - USE
FIGURED DIMENSIONS ONLY

PROJECT NO.

24-002


SHEET TITLE

ARCHITECTURAL

SITE PLAN

SHEET NUMBER

ASP-1

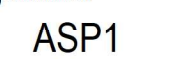

PARKING SPACES PROVIDED:
651 SURFACE PARKING SPACES
 33 ACC SURFACE SPACES PROVIDED (32.5 REQ)
6 VAN ACC SURFACE SPACES PROVIDED **35**
 GARAGES SPACES
 5 VAN ACC GARAGE SPACES PROVIDED
 (2 REQ)
 1 MAINTENANCE BAY
686 TOTAL PARKING SPACES (2.71 SPACES/DU)